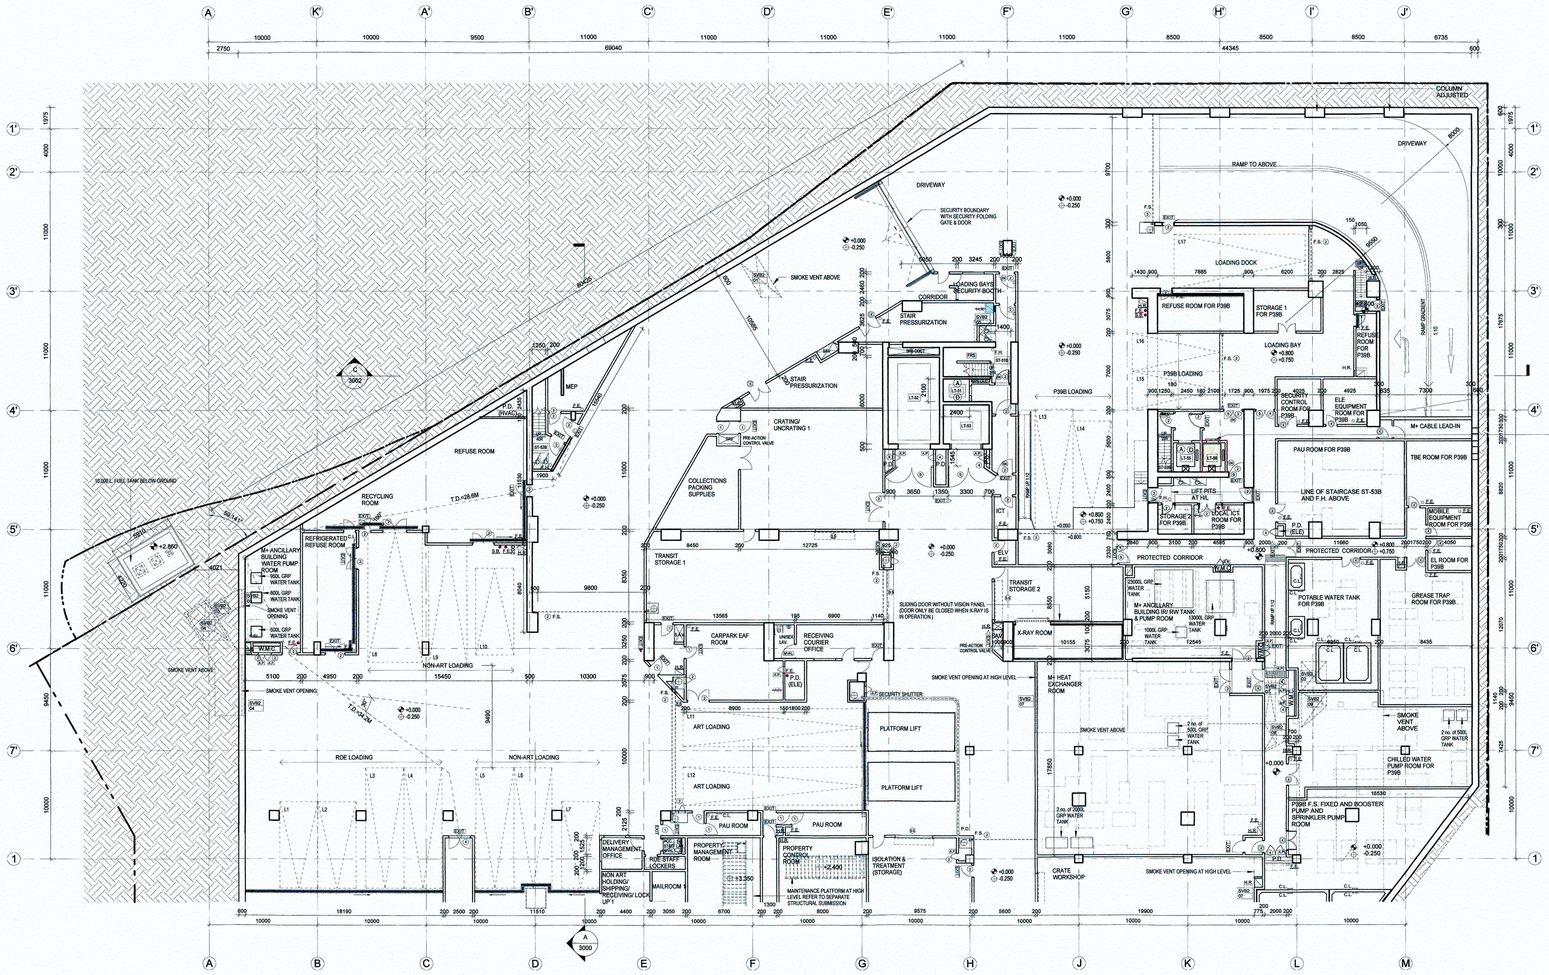


B2/F PLAN (2 OF 2)
1 : 200

RECEIVED BY
2020 JUN 22 P 5:05
BUILDING DEPARTMENT

B.D. REF: 2/4096/13 (P)
F.S.D REF:

KEY PLAN

KEY PLAN

NOTES:

PHASE 1

PHASE 2

Plan Approved
LI Kwok-chung Gordon
Senior Building Surveyor
for BUILDING AUTHORITY
- 3 JUL 2020

UNLESS NOTED OTHERWISE: COPYRIGHT AND DESIGN RIGHTS IN THIS DOCUMENT ARE OWNED BY ONE OR ALL OF THE MEMBERS OF THE M+ CONSULTANCY JV FORMING THE "CONSULTANT", WITHOUT DEROGATION TO ANY PROVISION OF THE CONSULTANCY AGREEMENT, THE CONSULTANT, RESPECTIVELY THE MEMBER OF THE M+ CONSULTANCY JV THAT OWNS SUCH INTELLECTUAL PROPERTY, HAS GRANTED AND GRANTS ONLY TO THE AUTHORITY, ITS SUCCESSORS AND ASSIGNS AND ANY PERSON AUTHORISED BY THE AUTHORITY A NON-EXCLUSIVE IRREVOCABLE WORLD-WIDE LICENCE (CARRYING THE RIGHT TO GRANT SUB LICENSES) TO USE, REPRODUCE, MODIFY, ADAPT AND TRANSLATE THE INTELLECTUAL PROPERTY IN THIS DOCUMENT FOR ANY PURPOSE OF THE AUTHORITY. NOTWITHSTANDING THE ABOVE MENTIONED LICENCE, THIS DOCUMENT SHALL NOT BE REPRODUCED, MODIFIED, ADAPTED OR TRANSLATED BY ANY MEMBER OF THE CONSULTANCY JV INDICATED AS HAVING PRODUCED THIS DOCUMENT. THE USE OF THIS DOCUMENT AND THE INTELLECTUAL PROPERTY VESTED THEREIN BY ANY OTHER PARTY THAN THOSE MENTIONED ABOVE MUST BE SUBJECT TO AN AGREEMENT OR AUTHORIZATION BY OR WITH THE AUTHORITY

REV.	DATE	PURPOSE OF RELEASE	PRODUCED BY
N	22.06.2020	GBP 16TH AMENDMENT	TFP
M	20.02.2020	GBP 15TH AMENDMENT	TFP
L	18.11.2019	GBP 14TH AMENDMENT	TFP
K	18.10.2019	GBP 13TH AMENDMENT	TFP
J	18.07.2019	GBP 12TH AMENDMENT	TFP
I	30.04.2019	GBP 11TH AMENDMENT	TFP
H	28.12.2017	GBP 9TH AMENDMENT	TFP
G	27.05.2016	GBP 8TH AMENDMENT	TFP
F	27.05.2016	GBP 7TH AMENDMENT	TFP
E	05.02.2016	GBP 4TH AMENDMENT	TFP
D	28.12.2015	GBP 3RD AMENDMENT	TFP
C	23.06.2015	GBP 2ND AMENDMENT	TFP

CONSULTANT
M+ CONSULTANCY JV

DESIGN CONSULTANT
HERZOG & DE MEURON
HERZOG & DE MEURON BASEL LTD., RHEINSCHANZE 6, CH 4056 BASEL, SWITZERLAND

EXECUTIVE ARCHITECT
TFP | FARRELLS
TFP FARRELLS LIMITED, SUITES 1301-02, 13/F, 625 KING'S ROAD, NORTH POINT, HONG KONG

ENGINEERING CONSULTANT
ARUP
OVE ARUP & PARTNERS HONG KONG LIMITED, LEVEL 5 FESTIVAL WALK, 80 TAT CHEE AVENUE, KOWLOON TONG, HONG KONG.

MJV-SUBCONSULTANT

AUTHORITY'S CONSULTANT

QUANTITY SURVEYOR
LangdonSeah
AN AECOM COMPANY

JOB TITLE
MUSEUM PLUS (M+) OF THE WEST KOWLOON CULTURAL DISTRICT

DRAWING TITLE
B2/F PLAN (2 OF 2)

SCALE	1:200 (@ A0)	PRINTED	22.06.2020
CHECKED	DL	DATE	22.06.2020
APPROVED	FL	DATE	22.06.2020
PRODUCED BY	KL	DATE	22.06.2020
AUTHOR	TFP		
DISCIPLINE	ARC		
PHASE	GBP		
DRAWING NO.	3AXXX-TFP-ARC-DWG-0982-P00-LB02-GBP	REV.	N

CAD REF NAME: 3AXXX-TFP-ARC-DWG-0982-P00-LB02-GBP-N.dwg

AUTHORITY

westKowloon
西九文化區

Note: This plan has been processed on a current check basis under the centralized processing system as promulgated in PNAP ADM-19. The duties of the authorized person, registered structural engineer, registered geotechnical engineer, nominated as specified under section 4(1)(b) and the provision of section 16(2)(c) of the Buildings Ordinance are not affected by anything in this stamp.

"THE WORKS SHOWN ON THESE PLANS ARE TYPE I WORKS (GENERAL BUILDING WORKS) IN RESPECT OF WHICH CONSENT IS APPLIED FOR THE PURPOSE OF FAST TRACK CONSENT APPLICATION UNDER REGULATION 33 OF THE BUILDING (ADMINISTRATION) REGULATIONS."

LI KWOK-HING
REGISTERED ARCHITECT
AUTHORIZED PERSON (ARCHITECT)
AP (A) 39/05

RECORD PLAN

A0 (1189mm x 840mm) Sheet Size